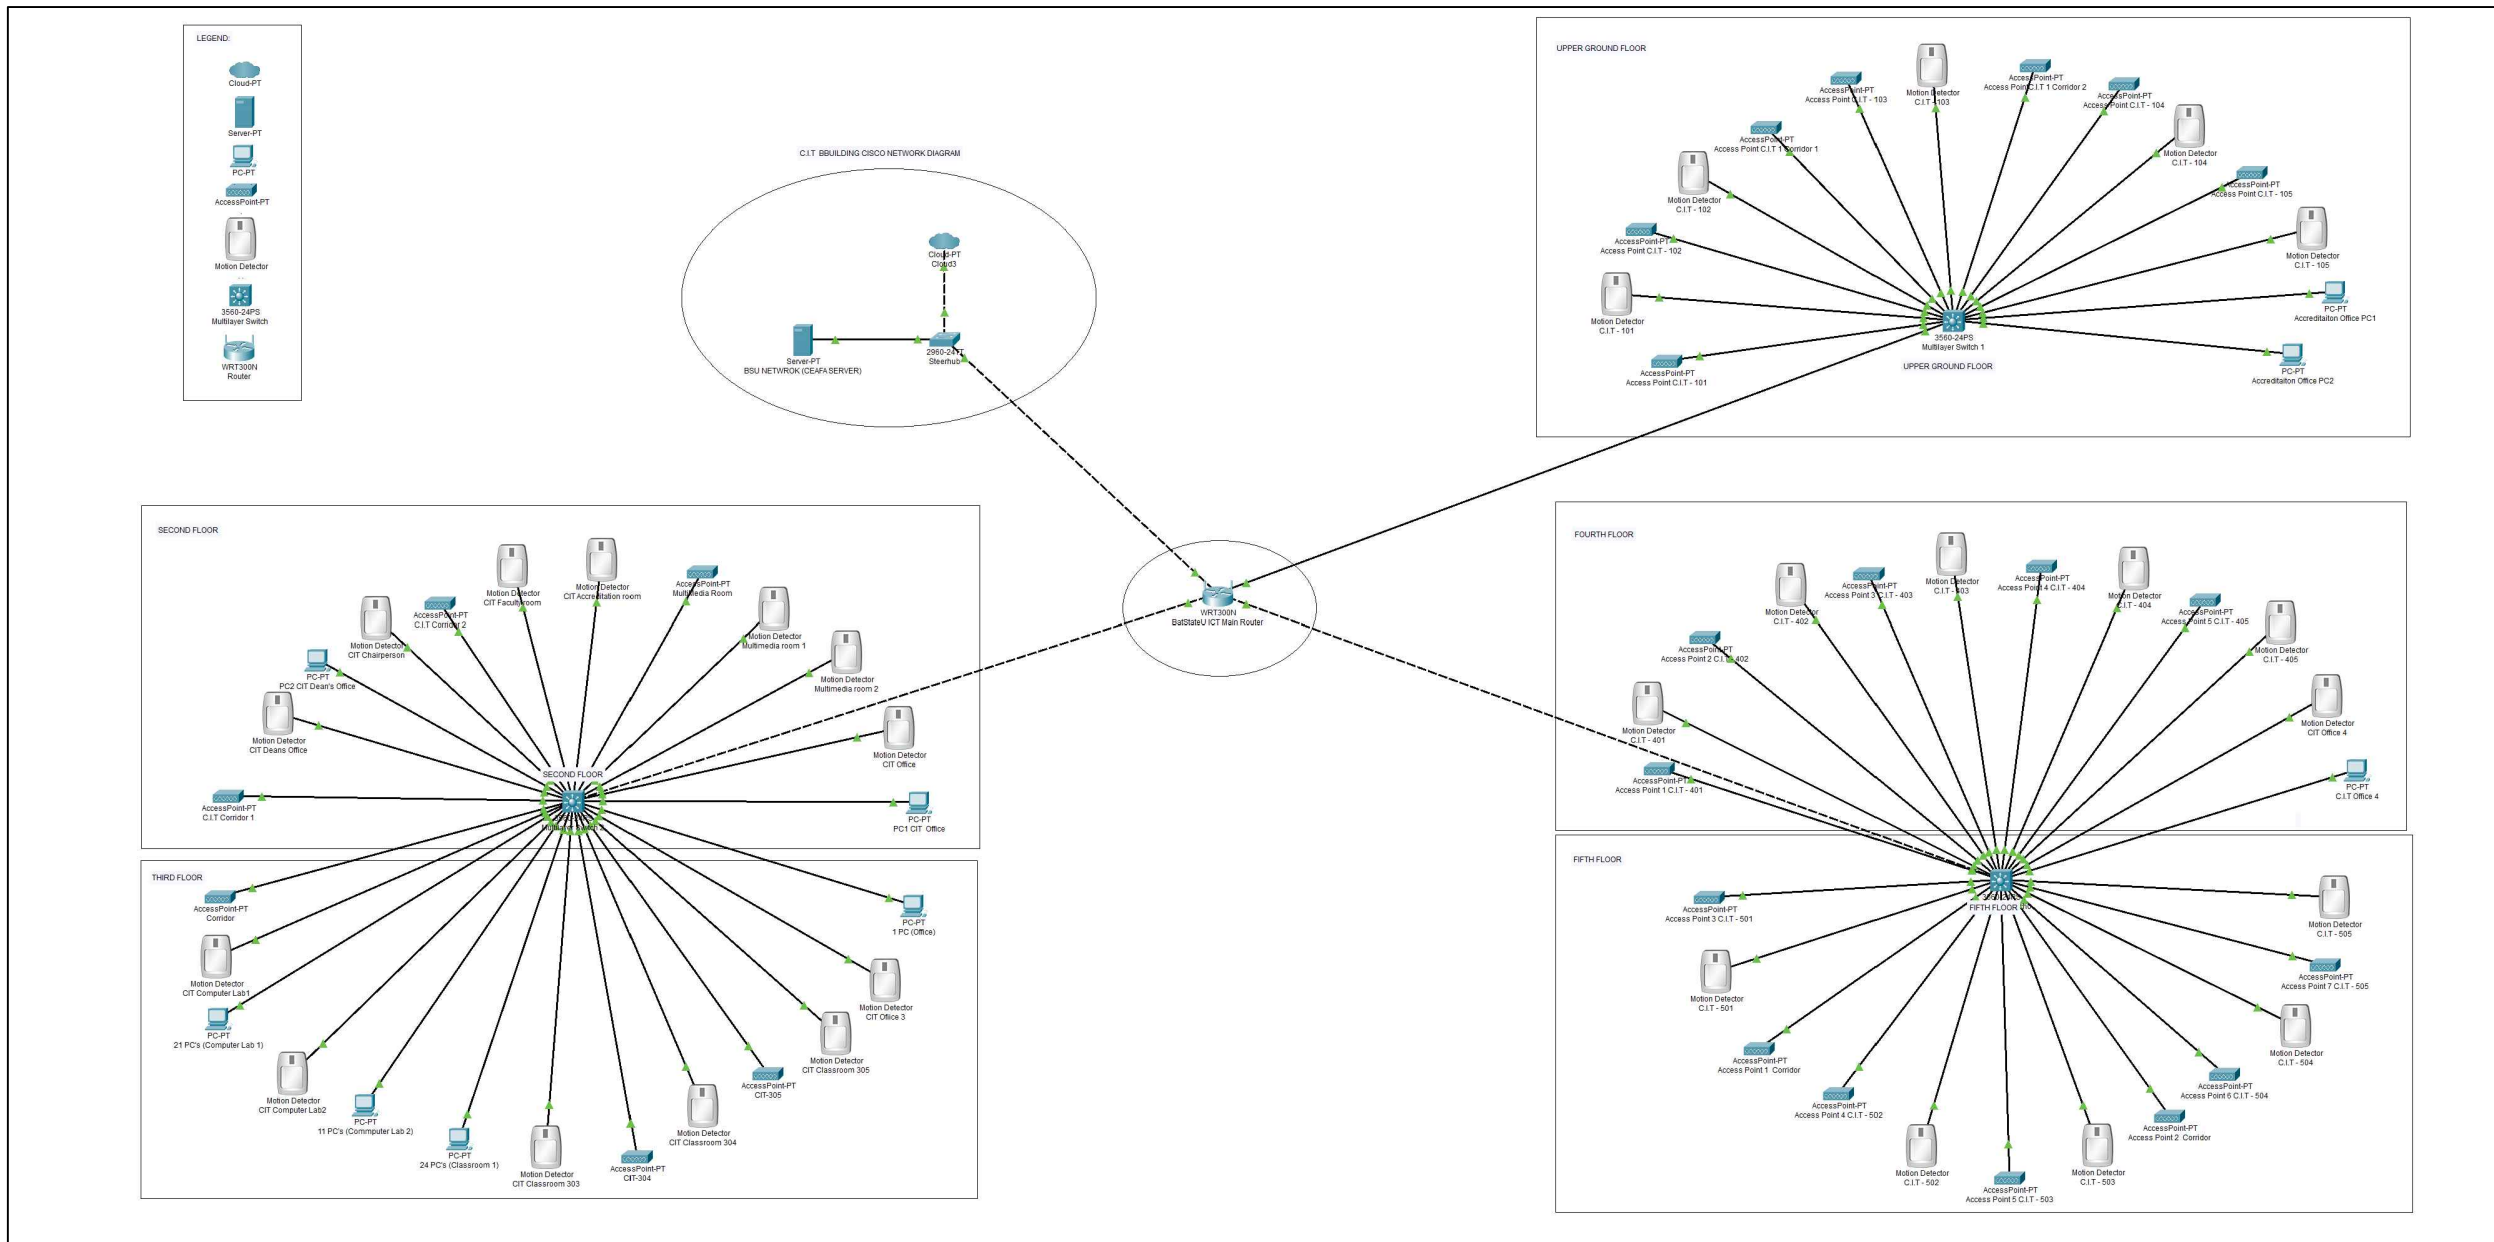


FIVE STOREY BATSTATEU CIT BUILDING
NETWORK SYSTEM RISER DIAGRAM
SCALE: 1:100 M

COMPANY LOGO:		COMPANY NAME:	PROJECT/LOCATION	OWNER	DESIGNED	NO.	REVISIONS	DATE	SUBMITTED TO:	SHEET CONTENT	SHEET NO.
		DENAHRA ENGINEERING SERVICES	[CCTV LAYOUT/FDAS LAYOUT/FDAS RISER DIAGRAM/CCTV RISER DIAGRAM/CISCO DIAGRAM] OF INFORMATICS AND COMPUTER SCIENCES BUILDING	BATANGAS STATE UNIVERSITY	DRAWN/CAD:				ENGR. GIL B. BARTE, PhD ECEEE 402 INSTRUCTOR	CCTV RISER DIAGRAM (AS BUILT)	A 4/4
		SQUADRON MONITORING SYSTEM									
		L.A.C.S. CORPORATION		DR. TIRSO A. RONQUILLO UNIVERSITY PRESIDENT	CHECKED:						
		MODERN MULTIPURPOSE INNOVATIVE CORP.									
		SWIFT TECHNOLOGIES	BATSTATEU ALANGILAN CAMPUS GOLDEN COUNTRY HOMES SUBD., ALANGILAN, BATANGAS	DATE:							
		ELECTRONICS OPTIMUM BANDWIDTH FACILITIES									