
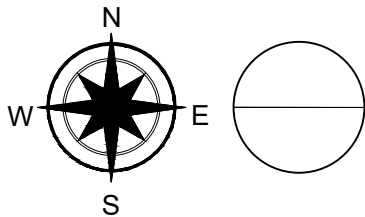


LEGEND:

NOT TO SCALE

 - CCTV BULLET TYPE

 - CCTV DOME TYPE

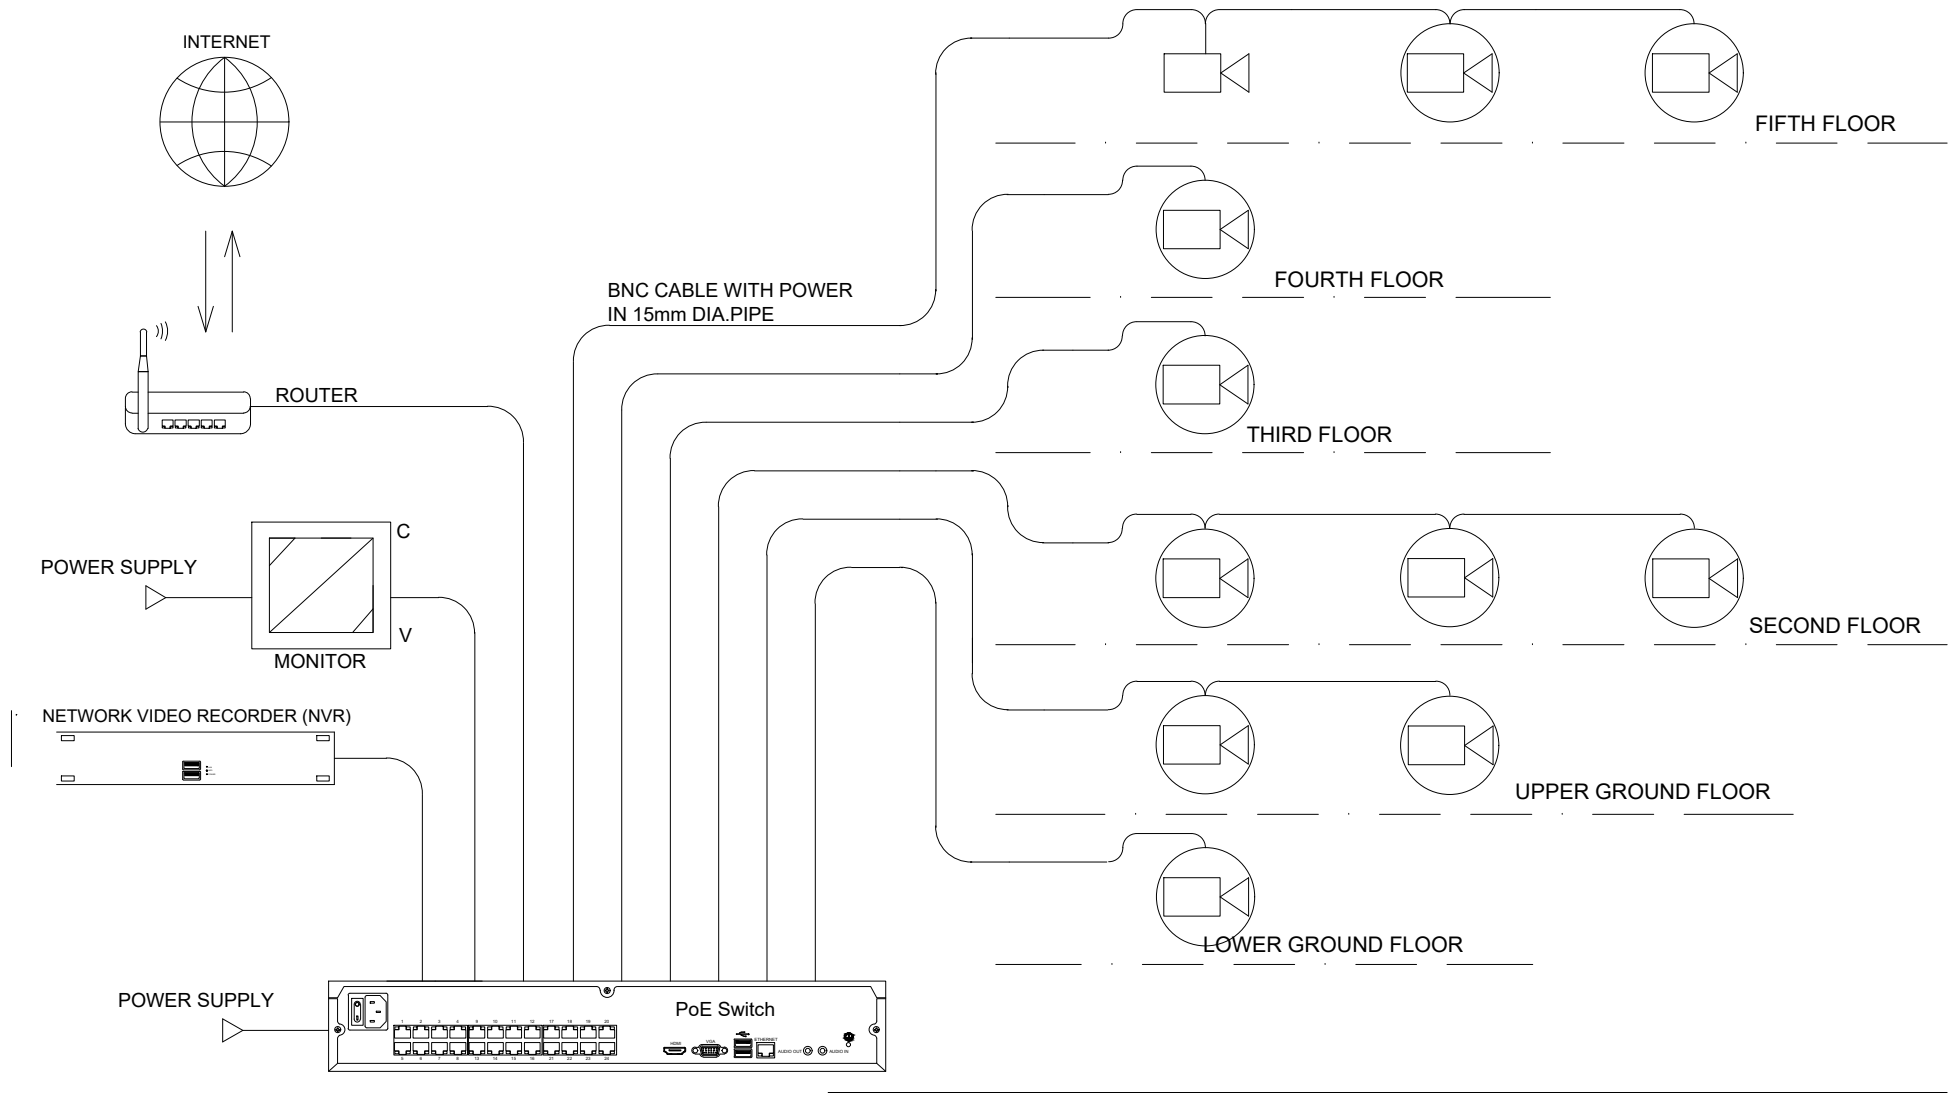

FIVE STOREY BATSTATEU CIT BUILDING

# CCTV SYSTEM RISER DIAGRAM

SCALE: 1:100 M

| COMPANY LOGO:                                                                       |                                                                                     | COMPANY NAME:                        | PROJECT/LOCATION                                                                                                            | OWNER                                          | DESIGNED   | NO. | REVISIONS | DATE | SUBMITTED TO:                                   | SHEET CONTENT                       | SHEET NO.       |
|-------------------------------------------------------------------------------------|-------------------------------------------------------------------------------------|--------------------------------------|-----------------------------------------------------------------------------------------------------------------------------|------------------------------------------------|------------|-----|-----------|------|-------------------------------------------------|-------------------------------------|-----------------|
|  |  | DENAHRA ENGINEERING SERVICES         | [CCTV LAYOUT/FDAS LAYOUT/FDAS RISER DIAGRAM/CCTV RISER DIAGRAM/CISCO DIAGRAM] OF INFORMATICS AND COMPUTER SCIENCES BUILDING | BATANGAS STATE UNIVERSITY                      | DRAWN/CAD: |     |           |      | ENGR. GIL B. BARTE, PhD<br>ECEEE 402 INSTRUCTOR | CCTV<br>RISER DIAGRAM<br>(AS BUILT) | <div>A4/4</div> |
|                                                                                     |  | L.A.C.S. CORPORATION                 |                                                                                                                             | DR. TIRSO A. RONQUILLO<br>UNIVERSITY PRESIDENT | CHECKED:   |     |           |      |                                                 |                                     |                 |
|                                                                                     |  | SWIFT TECHNOLOGIES                   |                                                                                                                             |                                                | DATE:      |     |           |      |                                                 |                                     |                 |
|  |                                                                                     | MODERN MULTIPURPOSE INNOVATIVE CORP. | BATSTATEU ALANGILAN CAMPUS<br>GOLDEN COUNTRY HOMES SUBD., ALANGILAN, BATANGAS                                               |                                                |            |     |           |      |                                                 |                                     |                 |