


FIVE STOREY BATSTATEU CIT BUILDING FIFTH FLOOR LAYOUT

SCALE: 1:100 M

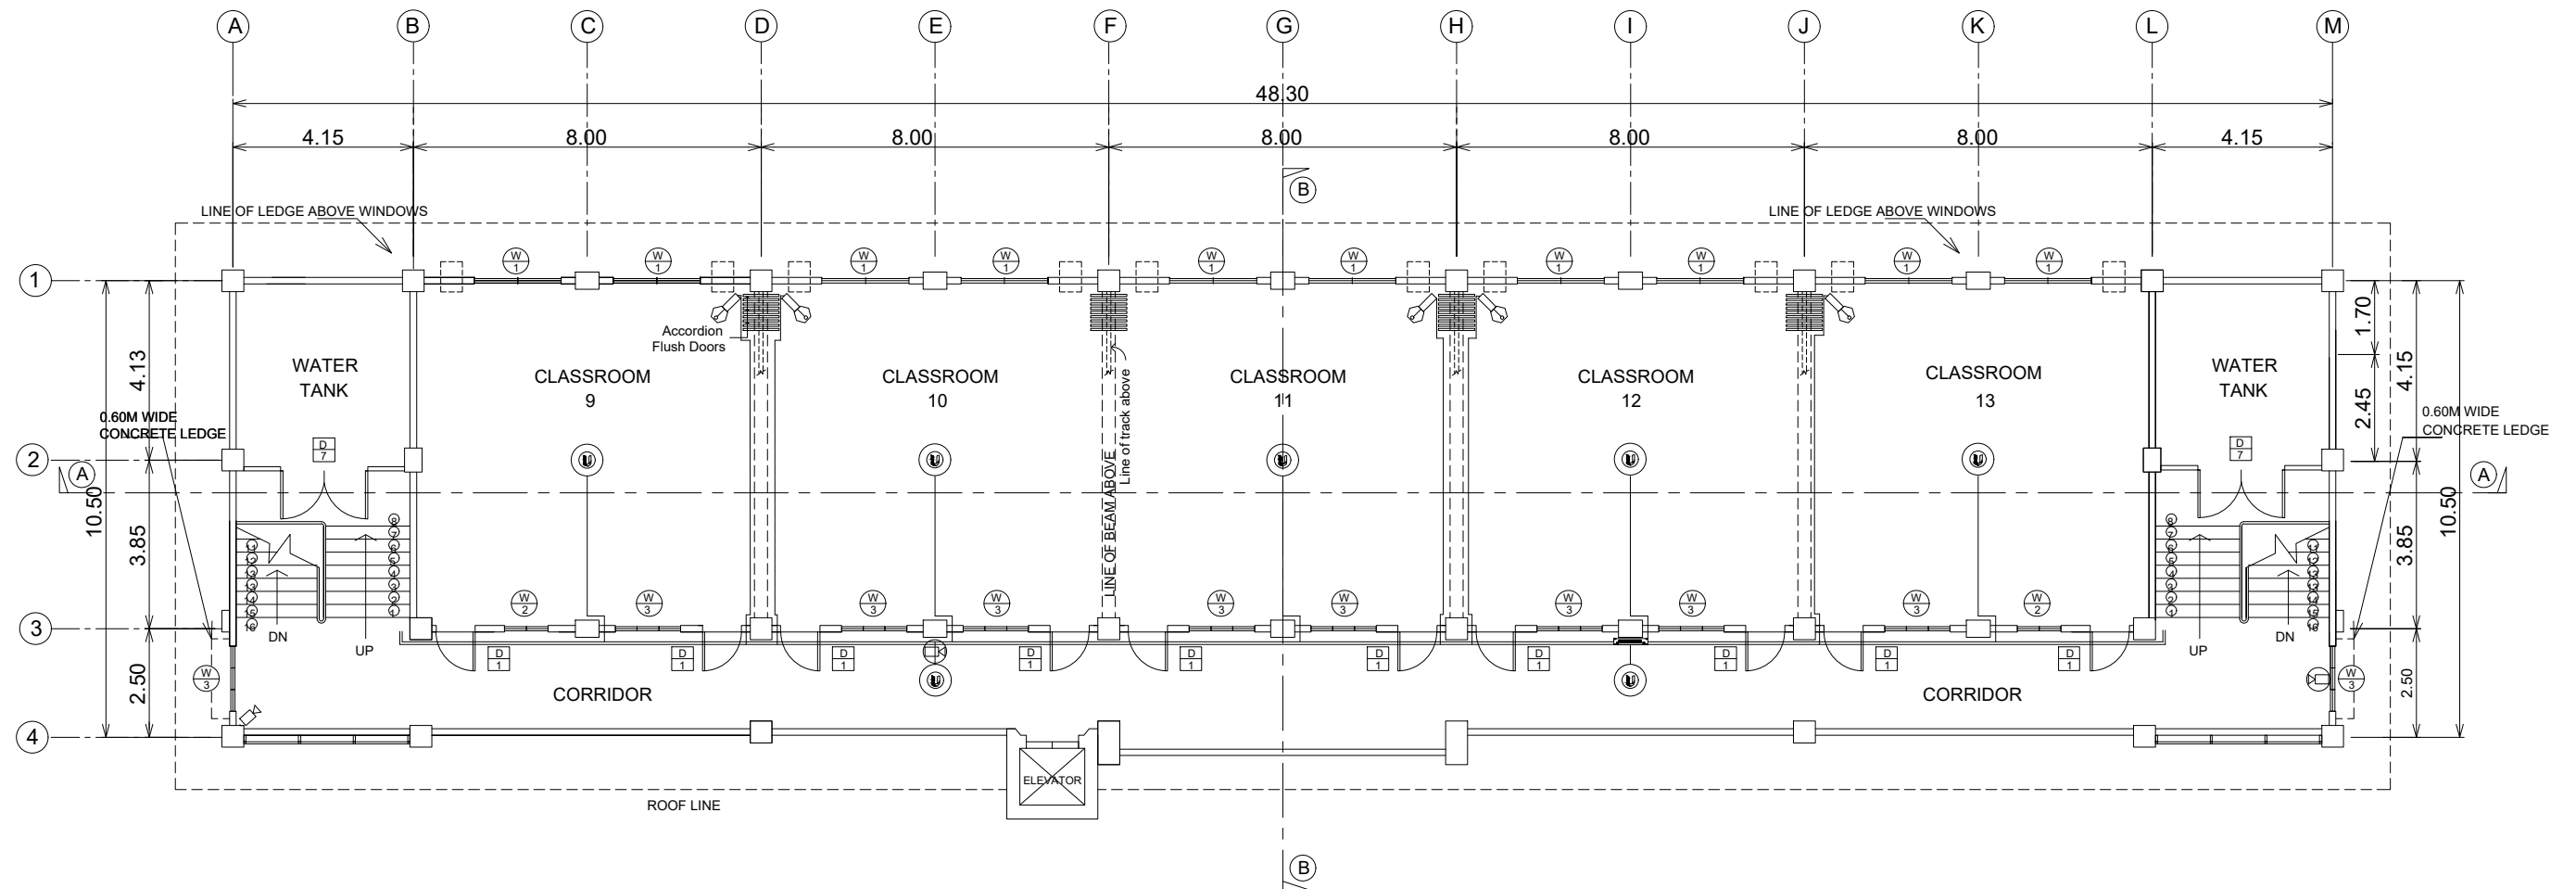

ELECTRONIC
OPTIMUM
BANDWIDTH
FACILITIES

ARCHITECT/CIVIL ENGINEER		
EVANGELESTA, LESTER JOHN ORTIZ, JOHN CARL P. BENEDICTO, KRISTINE C. FAJUTNAO, MANUELITO JR. M.		
PRC Reg No.	Valid until:	TIN:
PTR No.	Issued on:	Issued at:

PROJECT / LOCATION:
FIVE STOREY BATSTATEU CIT BUILDING
BatstateU Alangilan Campus Golden Country, Alangilan, Batangas City

OWNER
BATANGAS STATE UNIVERSITY
DR. TIRSO A. RONQUILLO UNIVERSITY PRESIDENT

DESIGNED:
DRAWN/CAD:
CHECKED:
DATE:

AS-BUILT PLAN

SHEET CONTENT	SHEET NO.
FIFTH FLOOR PLAN	A 2/4