


FIVE STOREY BATSTATEU CIT BUILDING FOURTH FLOOR LAYOUT

SCALE: 1:100 M

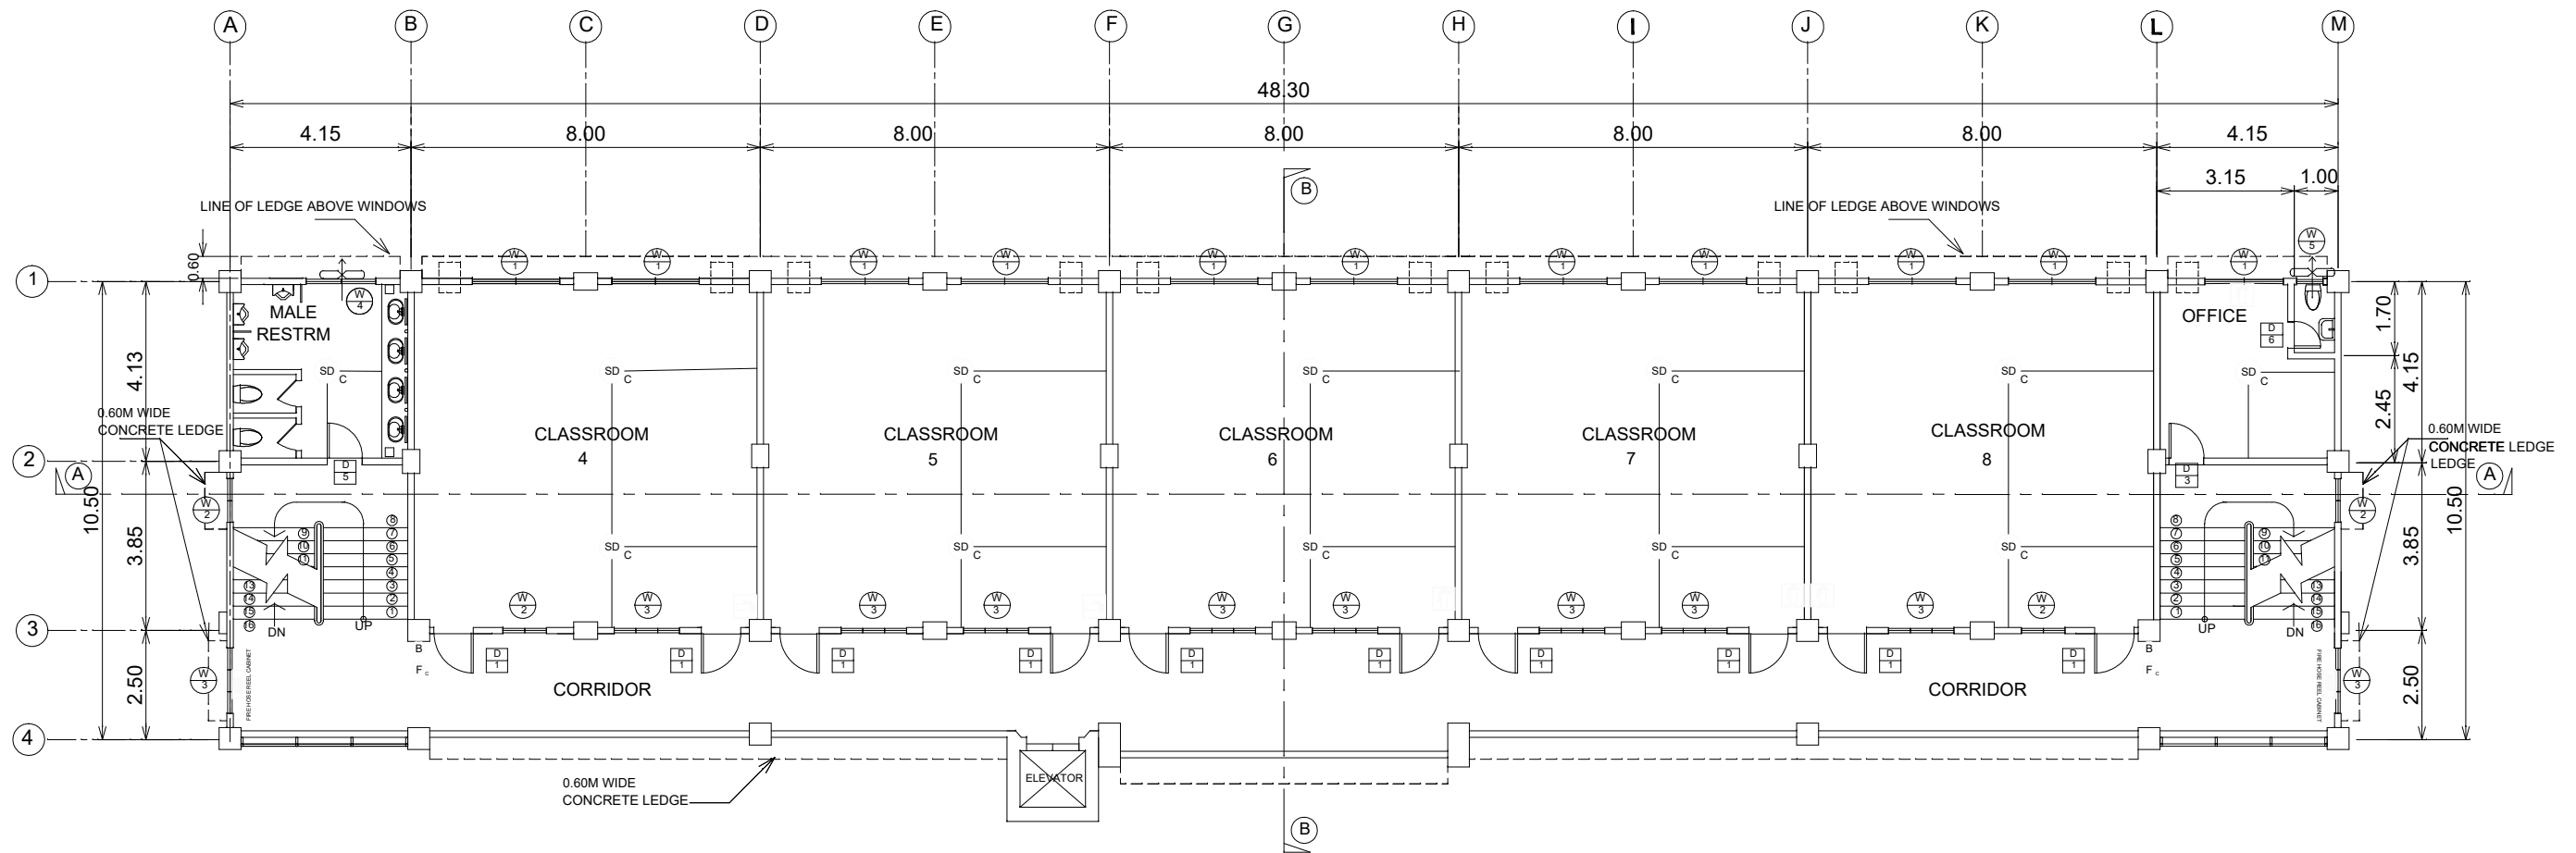

SWIFT
TECHNOLOGIES

ARCHITECT/CIVIL ENGINEER		
GUINO, CEDRICK M. MACARAIG, EVAN GERANLD S. VERGARA, NICOLE NASH ANDREA		
PRC Reg No.	Valid until:	TIN:
PTR No.	Issued on:	Issued at:

SEAL

PROJECT / LOCATION:
FIVE STOREY BATSTATEU CIT BUILDING
BatstateU Alangilan Campus Golden Country, Alangilan, Batangas City

OWNER
BATANGAS STATE UNIVERSITY
DR. TIRSO A. RONQUILLO UNIVERSITY PRESIDENT

DESIGNED:
DRAWN/CAD:
CHECKED:
DATE:

AS-BUILT PLAN

SHEET CONTENT
FOURTH FLOOR PLAN

SHEET NO.
A 1/4