

GENERAL NOTES

NOT TO SCALE

1. ALL ELECTRICAL/ELECTRONICS CODE WORKS INDICATED ARE IN ACCORDANCE WITH:
- 1.1. NFPA 70 (NATIONAL ELECTRIC CODE) AND
 - 1.2. NFPA 72* (NATIONAL FIRE ALARM AND SIGNALING CODE*).
 - 1.3. NFPA 101 (LIFE SAFETY CODE)
 - 1.4. PHILIPPINES ELECTRONIC CODE
2. LOCAL PROTECTIVE SIGNALING SYSTEM SHALL BE INSTALLED AND TESTED IN ACCORDANCE WITH FIRE CODES OF THE PHILIPPINES.
3. LOCAL PROTECTIVE SIGNALING SYSTEM INSTALLATION SHALL BE PERFORMED/SUPERVISED BY QUALIFIED FIRE ALARM TECHNICIAN.
4. THE LOCATION OF THE CIRCUIT DISCONNECTING MEANS SHALL BE IDENTIFIED AT THE FIRE ALARM CONTROL UNIT.
5. METHOD OF WIRINGS IS COMBINATION OF EMT AND IMC: UNLESS OTHERWISE SPECIFIED IN DRAWINGS.
- 5.1. MINIMUM SIZE OF WIRES IS 3.5 mm² "THWN-2/THHN" FOR MAIN AND "TW" FOR GROUND UNLESS OTHERWISE SPECIFIED IN THE DRAWING.
 - 5.2. MINIMUM SIZE OF CONDUIT IS 20 mm NOMINAL DIAMETER. ALL CONDUITS SIZES ARE BASE ON COMMERCIAL SIZES.
 - 5.3. METHOD OF WIRING SHALL BE AS FOLLOWS: UNLESS OTHERWISE SPECIFIED IN THE DRAWINGS.
 - 5.3.1. NOT EMBEDDED IN CONCRETE:
 - = USE EMT SIZE NOT LARGER THAN 20mm DIAMETER FOR BRANCH CIRCUIT.
 - = USE IMC WITH SIZE LARGER THAN 20mm DIAMETER FOR BRANCH CIRCUIT AND FEEDER.
6. ALL WIRING, CABLE AND EQUIPMENT SHALL BE INSTALLED IN ACCORDANCE WITH THE LATEST PECE AND PEE CODE.
7. ALL WIRING SHALL BE RUN IN DEDICATED CONDUIT AND NEVER IN THE SAME CONDUIT WITH AC LINE POWER.
8. POWER LIMITED AND NON POWER LIMITED CIRCUIT SHALL BE RUN IN SEPARATE CONDUIT.
9. HIGH AND LOW VOLTAGE CIRCUITS SHALL BE RUN ON SEPARATE CONDUIT.
10. ELECTRICAL METALLIC CONDUIT (EMT) CONNECTORS SHALL BE THE ALL-STEEL COMPRESSING TYPE, WITH INSULATING THROATS.
11. ALL JUNCTION BOXES THAT ARE VISIBLE OR ACCESSIBLE SHALL BE PAINTED RED.
12. ALL WORKS SHALL CONFORM TO THE PROVISIONS OF THE LATEST EDITION OF THE PHILIPPINE ELECTRONICS CODES AND THE RULES AND REGULATIONS OF THE LOCATION OF THE WORK.
13. WHERE THE PLANS DO NOT INDICATE THE MOUNTING HEIGHT FOR THE DEVICES/EQUIPMENT, THE FIRE ALARM CONTRACTOR SHALL INSTALL THEM IN ACCORDANCE WITH THE NFPA 72, NATIONAL FIRE ALARM CODE, AND LATEST PECE CODE UNLESS INSTRUCTED OTHERWISE BY THE LOCAL AUTHORITY HAVING JURISDICTION.
14. DETECTORS SHALL NOT BE INSTALLED IN DIRECT AIRFLOW NOR CLOSER 3 FEET FROM AN AIR SUPPLY DIFFUSER. THE FIRE ALARM CONTRACTOR SHALL FIELD VERIFY EXACT LOCATION FOR THE INSTALLATION OF ALL DETECTORS.
15. ALL JUNCTION BOXES THAT ARE VISIBLE OR ACCESSIBLE SHALL BE PAINTED RED.
16. CONTRACTOR SHALL SECURE ALL WIRING PERMIT AND ALL FEES REQUIRED FOR THE WORKS AND FURNISH THE OWNER THE CERTIFICATE OF FINAL INSPECTION.
17. T-TAPPING IS PERMITTED ON CLASS B WIRING ONLY
18. ALL UNDERGROUND PIPING AND CABLING SHOULD CONFORM TO MINIMUM DEPTH REQUIREMENTS AS SPECIFIED BY THEIR OWN RESPECTIVE STANDARDS.

SUMMARY:

NOT TO SCALE

- 65 - CONVENTIONAL SMOKE DETECTOR
- 12 - FIRE ALARM BELL
- 28 - SPRINKLER
- 13 - CONVENTIONAL MANUAL PULL STATION
- 26 - END OF LINE RESISTOR
- 1SET - 1.5mm² TF WIRE IN 15mm DIA. PIPE
- 1 - POWER SUPPLY
- 1 - CONVENTIONAL FIRE ALARM CONTROL PANEL 26 ZONES


LEGEND:

NOT TO SCALE

- CONVENTIONAL SMOKE DETECTOR
- FIRE ALARM BELL
- SPRINKLER
- CONVENTIONAL MANUAL PULL STATION
- PULL BOX
- END OF LINE RESISTOR
- CONVENTIONAL FIRE ALARM CONTROL PANEL



MOUNTING DIAGRAM:

NOT TO SCALE:

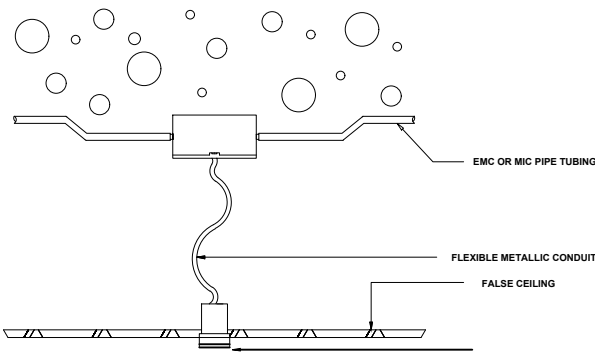

FIELD DEVICE MOUNTING DETAILS

NOT TO SCALE

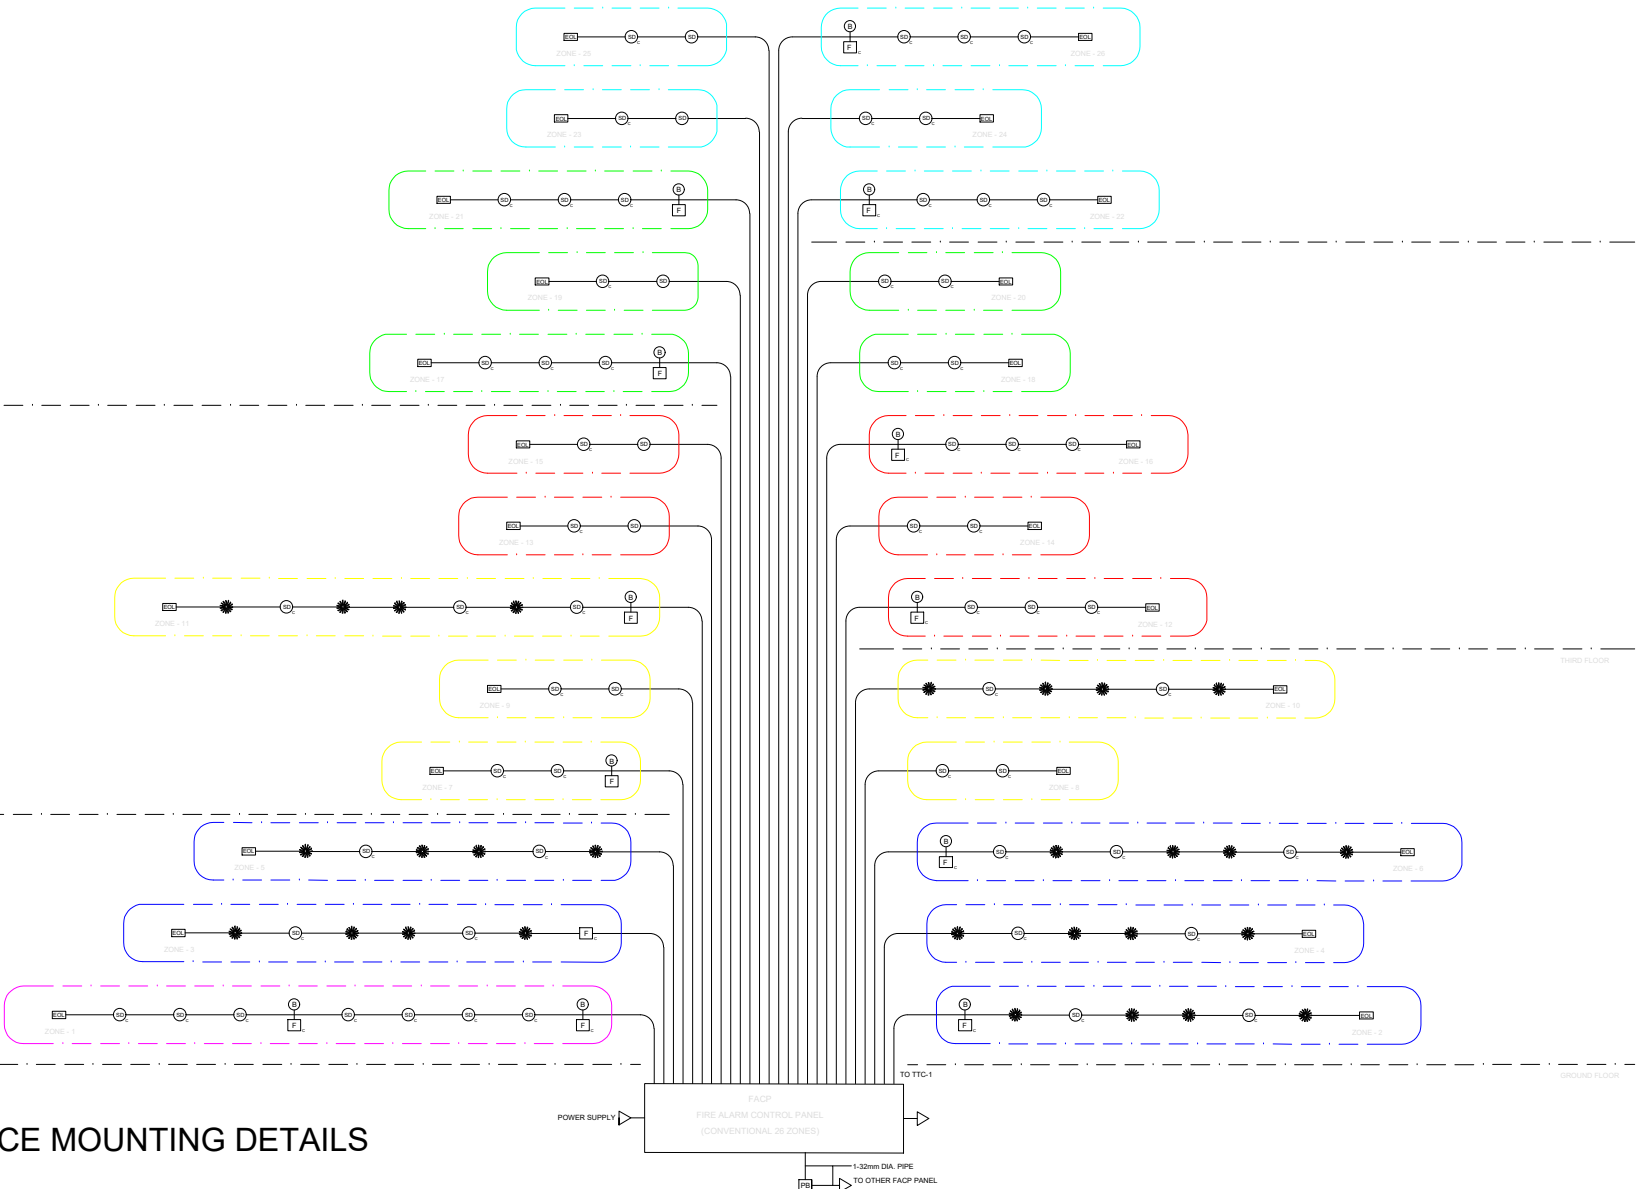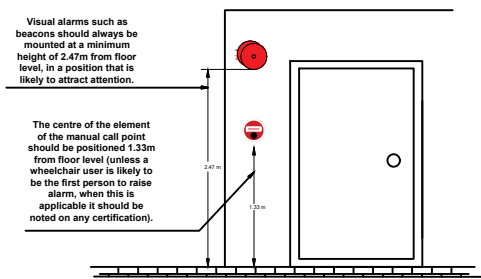

FIRE ALARM DETECTION AND ALARM SYSTEM RISER DIAGRAM
NOT TO SCALE

COMPANY LOGO:		COMPANY NAME:	PROJECT/LOCATION	OWNER	DESIGNED	NO.	REVISIONS	DATE	SUBMITTED TO:	SHEET CONTENT	SHEET NO.
		DENAHRA ENGINEERING SERVICES	[CCTV LAYOUT/FDAS LAYOUT/FDAS RISER DIAGRAM/CCTV RISER DIAGRAM/CISCO DIAGRAM] OF FIVE STOREY BATSTATEU CIT BUILDING	BATANGAS STATE UNIVERSITY DR. TIRSO A. RONQUILLO UNIVERSITY PRESIDENT	DRAWN/CAD:				ENGR. GIL B. BARTE, PhD ECEEE 402 INSTRUCTOR	RISER DIAGRAM (AS BUILT)	A3/4
		L.A.C.S. CORPORATION			CHECKED:						
		SWIFT TECHNOLOGIES			DATE:						
		MODERN MULTIPURPOSE INNOVATIVE CORP.	BATSTATEU ALANGILAN CAMPUS GOLDEN COUNTRY HOMES SUBD., ALANGILAN, BATANGAS								