


FIVE STOREY BATSTATEU CIT BUILDING **THIRD FLOOR LAYOUT**

SCALE: 1:100 M

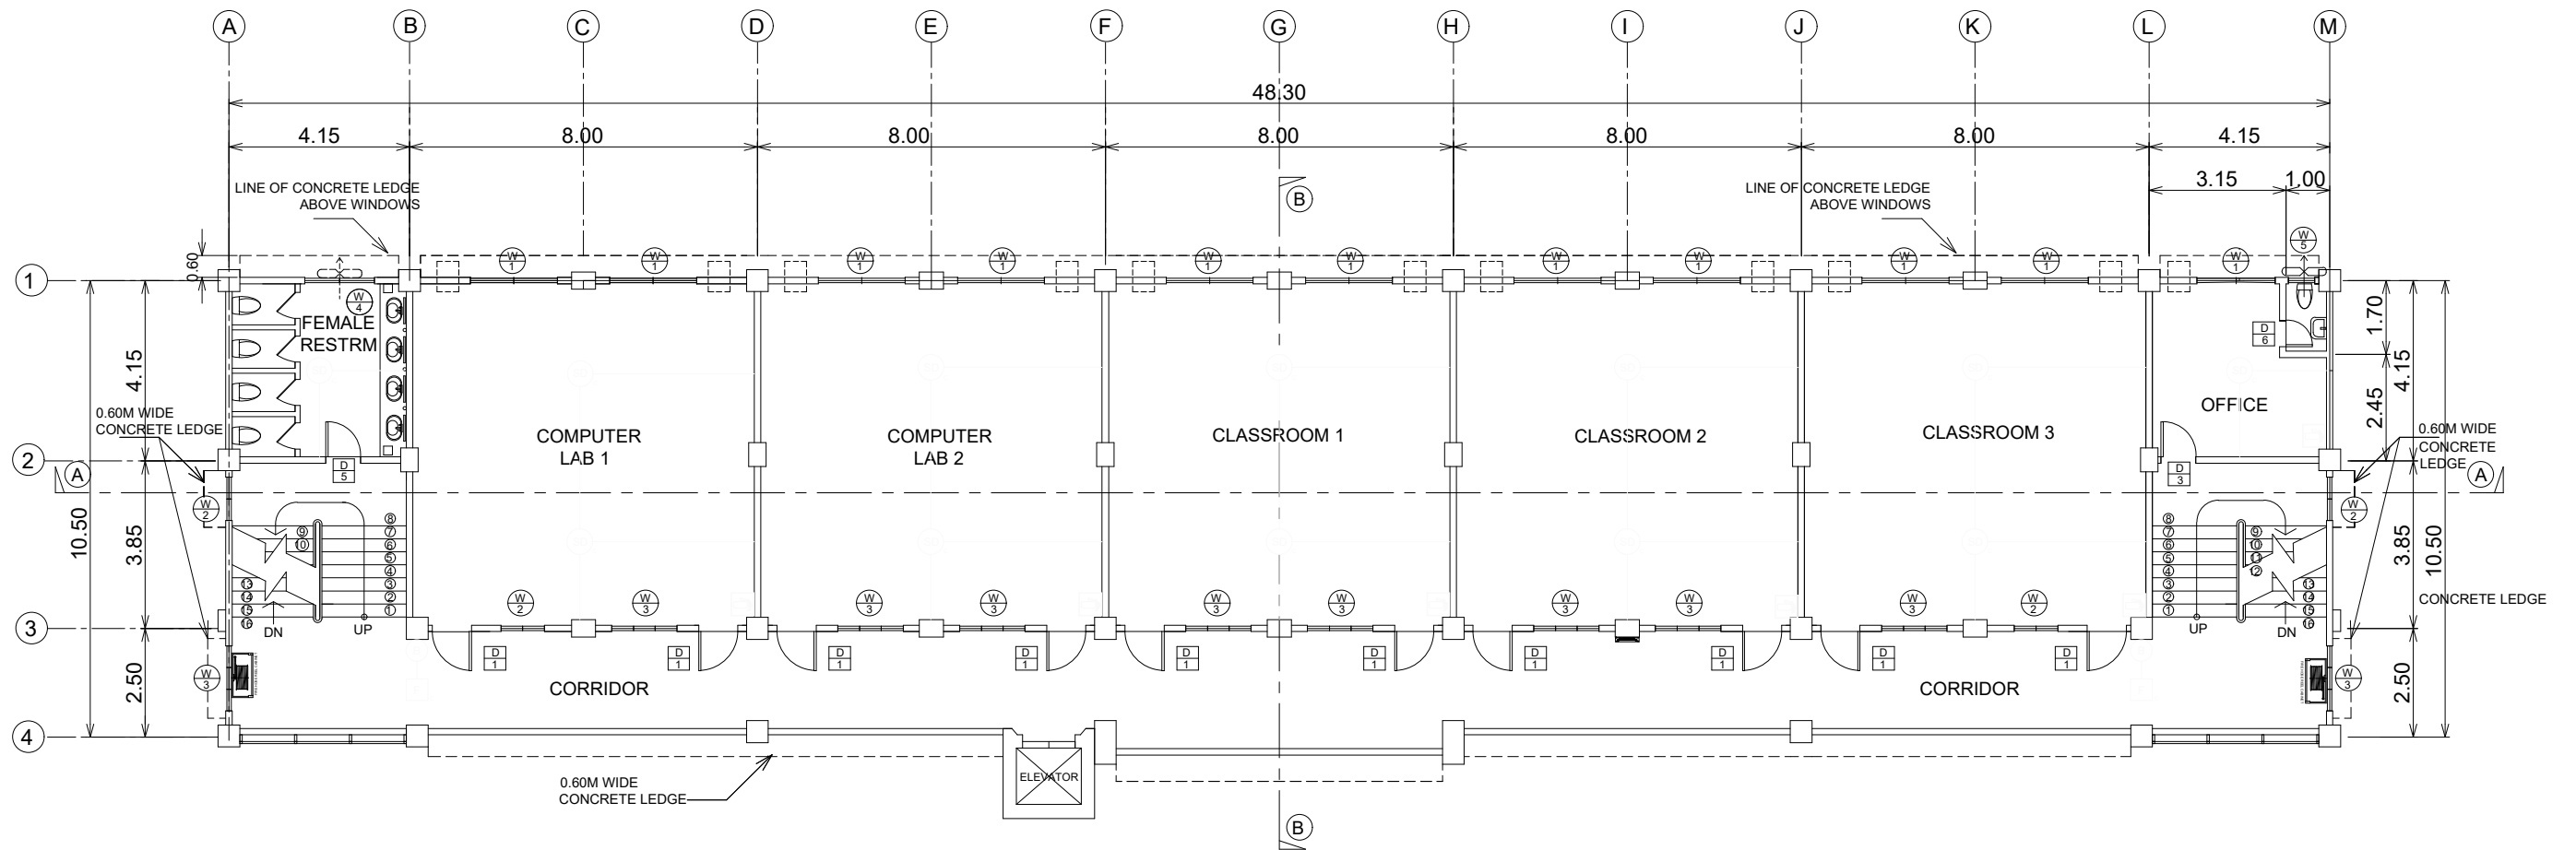

MODERN
 MULTIPURPOSE
 INNOVATION
 CORP.

ARCHITECT/CIVIL ENGINEER		
INGLES, JANINE MAE A. MAÑOSCA, AUBREY GRACE D. MANAY, MARIA ALE CZANDRA M.		
PRC Reg No.	Valid until:	TIN:
PTR No.	Issued on:	Issued at:

SEAL

PROJECT / LOCATION:
FIVE STOREY BATSTATEU CIT BUILDING
BatstateU Alangilan Campus Golden Country, Alangilan, Batangas City

OWNER
BATANGAS STATE UNIVERSITY
DR. TIRSO A. RONQUILLO UNIVERSITY PRESIDENT

DESIGNED:
DRAWN/CAD:
CHECKED:
DATE:

AS-BUILT PLAN

SHEET CONTENT	SHEET NO.
THIRD FLOOR PLAN	A 1/4