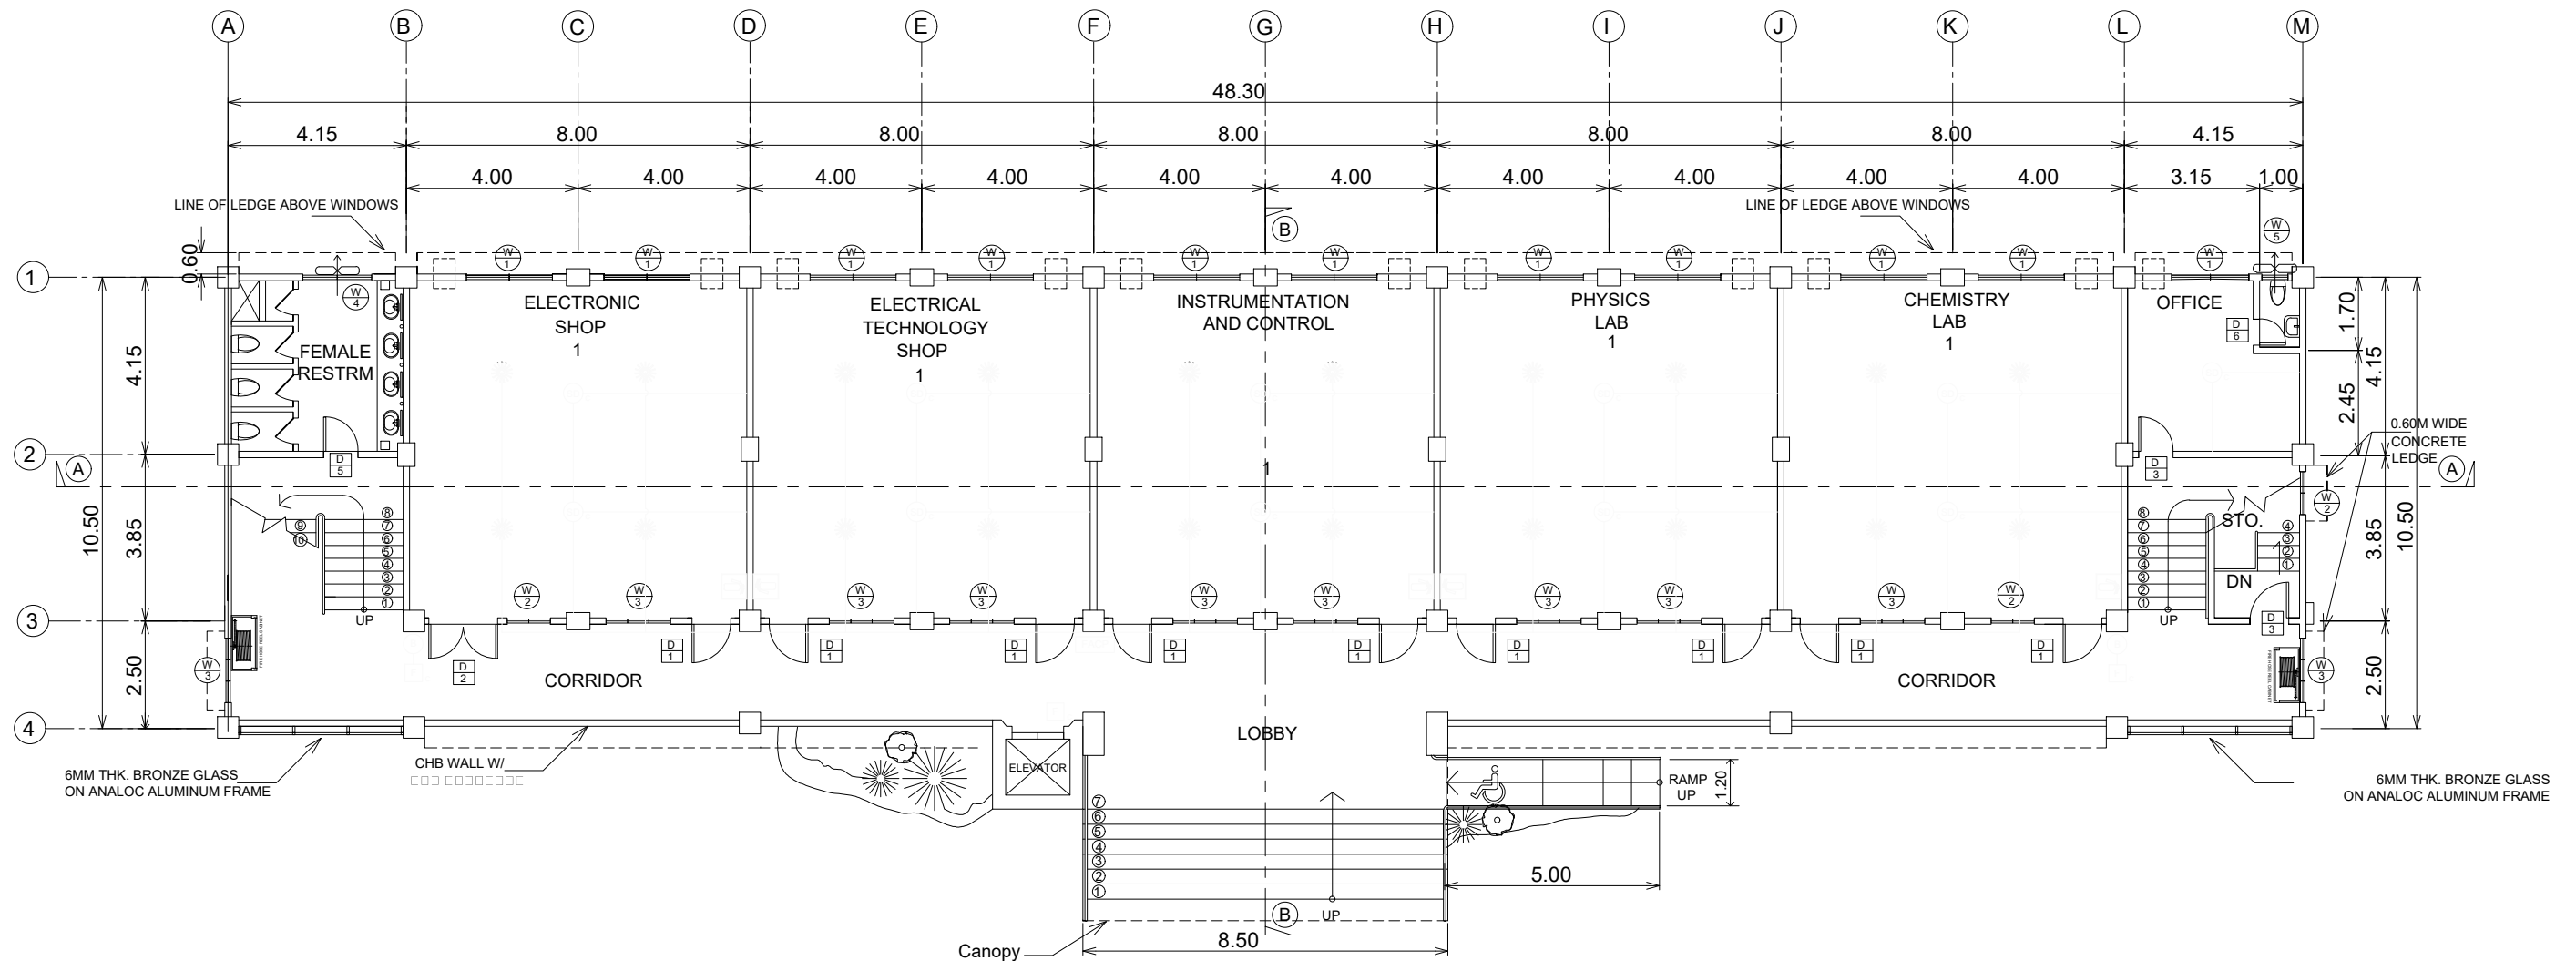


FIVE STOREY BATSTATEU CIT BUILDING

UPPER GROUND FLOOR LAYOUT

SCALE:

1:100 M

 SQUADRON MONITORING INCORPORATED	ARCHITECT/CIVIL ENGINEER		SEAL	PROJECT / LOCATION:	OWNER	DESIGNED:	AS-BUILT PLAN	SHEET CONTENT	SHEET NO.
	HERNANDEZ, ODRHEY SARMIENTO, JAMES CLINTON TRIVIO, ROCKEY MARZO			FIVE STOREY BATSTATEU CIT BUILDING	BATANGAS STATE UNIVERSITY	DRAWN/CAD:		UPPER GROUND FLOOR PLAN	A 1/4
	PRC Reg No. PTR No.	Valid until: Issued on:	TIN: Issued at:	BatstateU Alangilan Campus Golden Country, Alangilan, Batangas City	DR. TIRSO A. RONQUILLO UNIVERSITY PRESIDENT	CHECKED: DATE:			