


FIVE STOREY BATSTATEU CIT BUILDING THIRD FLOOR LAYOUT

SCALE:

1:100 M

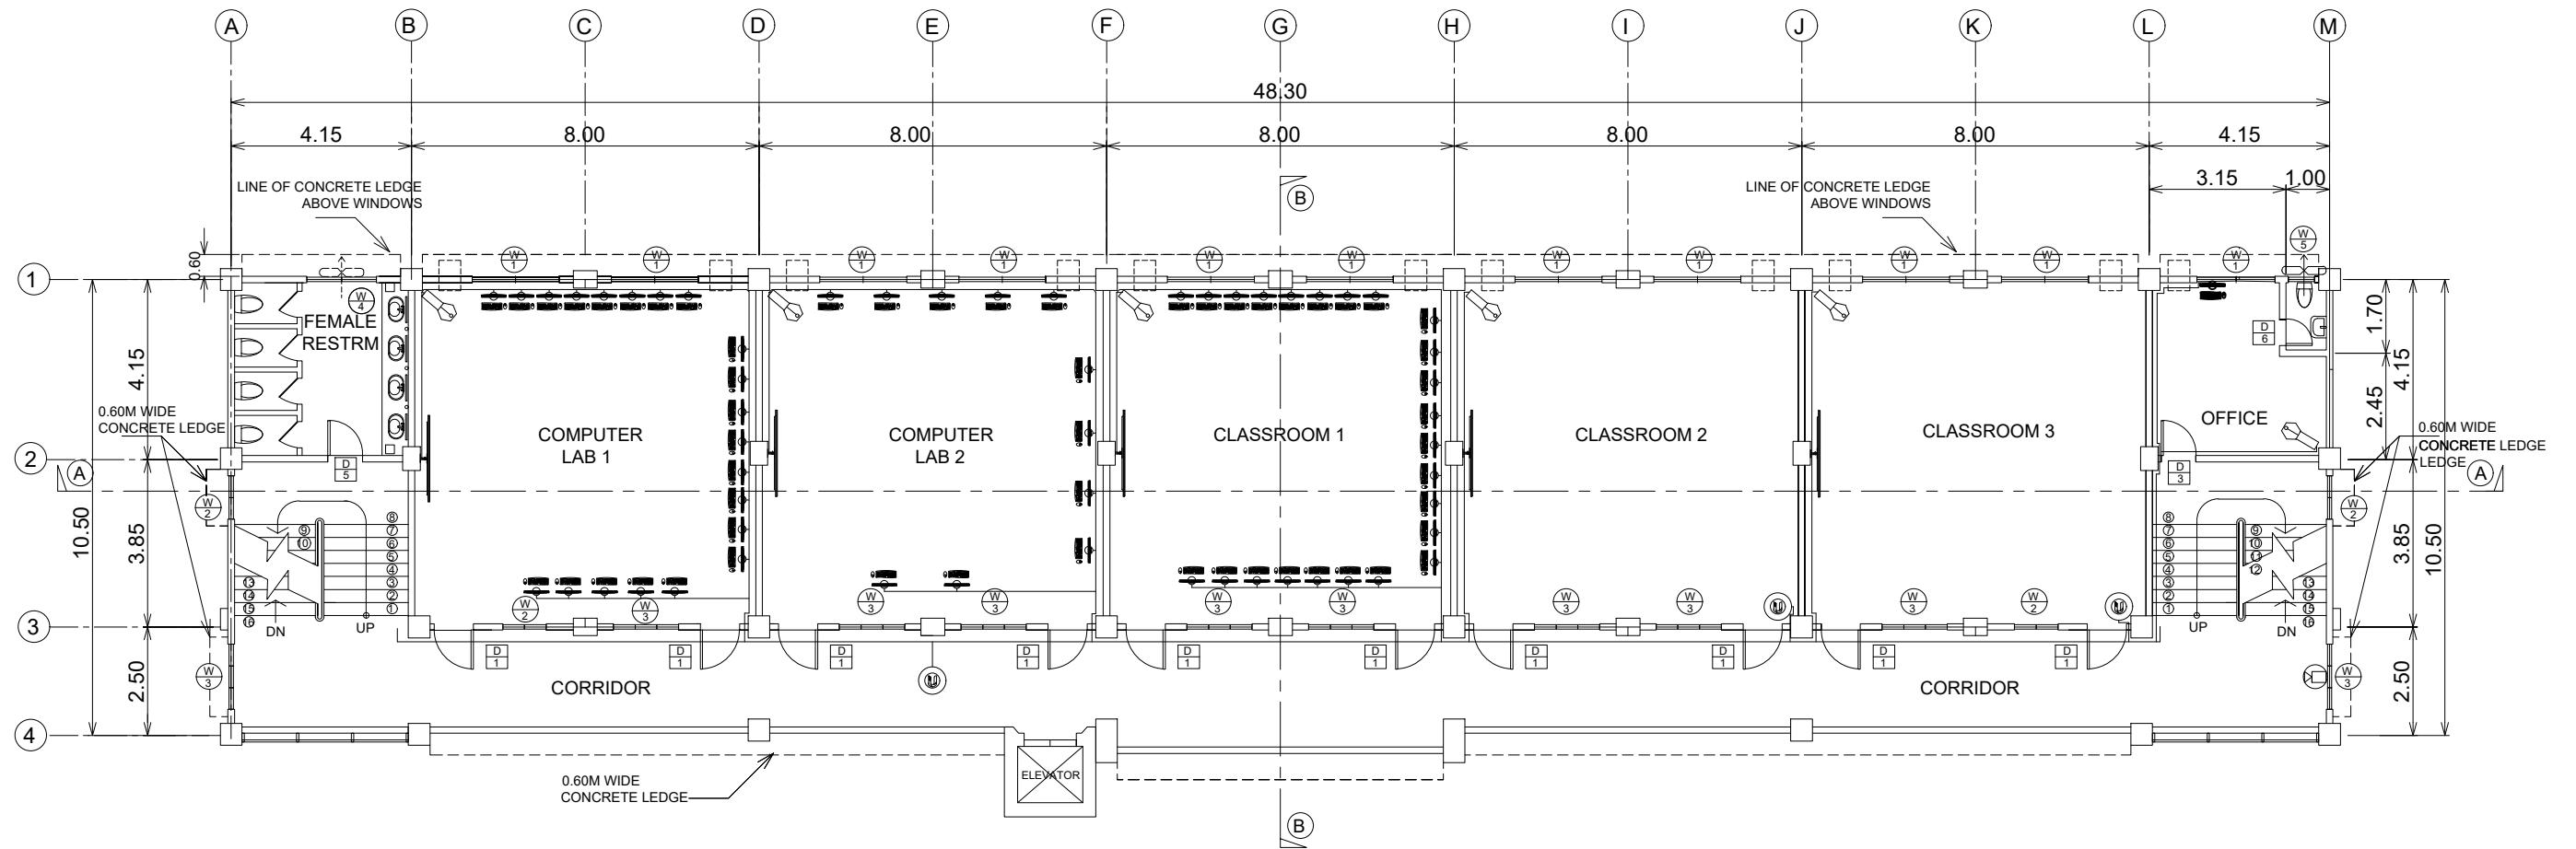

MODERN
MULTIPURPOSE
INNOVATION
CORP.

ARCHITECT/CIVIL ENGINEER

INGLES, JANINE MAE A.
MAÑOSCA, AUBREY GRACE D.
MANAY, MARIA ALECXANDRA M.

SEAL

PROJECT / LOCATION:

FIVE STOREY BATSTATEU CIT BUILDING

BatstateU Alangilan Campus
Golden Country, Alangilan, Batangas City

OWNER

BATANGAS STATE UNIVERSITY

DR. TIRSO A. RONQUILLO
UNIVERSITY PRESIDENT

DESIGNED:

DRAWN/CAD:

CHECKED:

DATE:

AS-BUILT PLAN

SHEET CONTENT

THIRD FLOOR PLAN

SHEET NO.

A
2/4