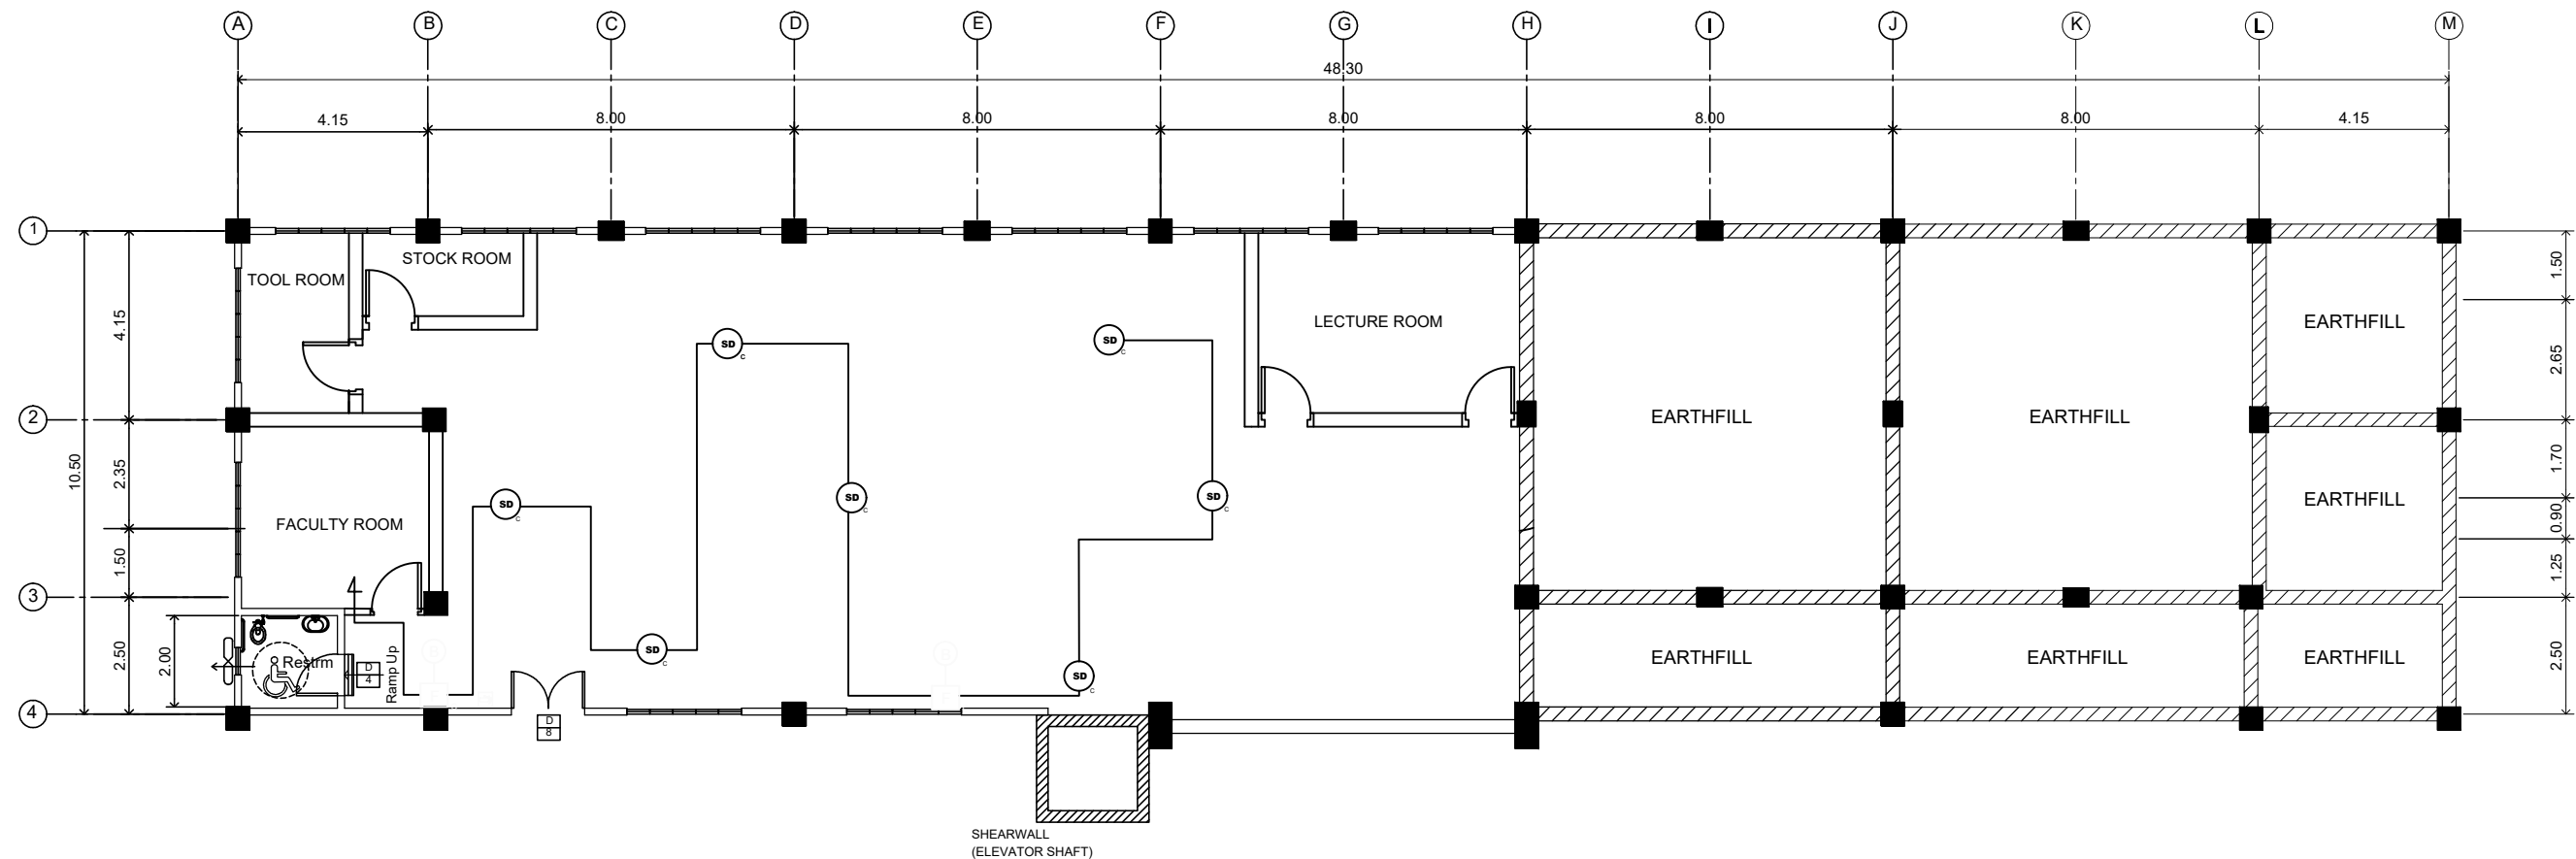


FIVE STOREY BATSTATEU CIT BUILDING

LOWER GROUND FLOOR LAYOUT

SCALE:

1:100 M

 DENAHRA ENGINEERING SERVICES	ARCHITECT/CIVIL ENGINEER			SEAL	PROJECT / LOCATION:	OWNER	DESIGNED:	AS-BUILT PLAN	SHEET CONTENT	SHEET NO.
	DELLOSA, JAIRA MAE C. DIMAILIG, JANNAH JAINRECH B. PANALIGAN DESERIE ALIANA M.				FIVE STOREY BATSTATEU CIT BUILDING	BATANGAS STATE UNIVERSITY	DRAWN/CAD:		LOWER GROUND FLOOR PLAN	A 1/4
	PRC Reg No.	Valid until:	TIN:	BatstateU Alangilan Campus Golden Country, Alangilan, Batangas City	DR. TIRSO A. RONQUILLO UNIVERSITY PRESIDENT	CHECKED:				
	PTR No.	Issued on:	Issued at:			DATE:				