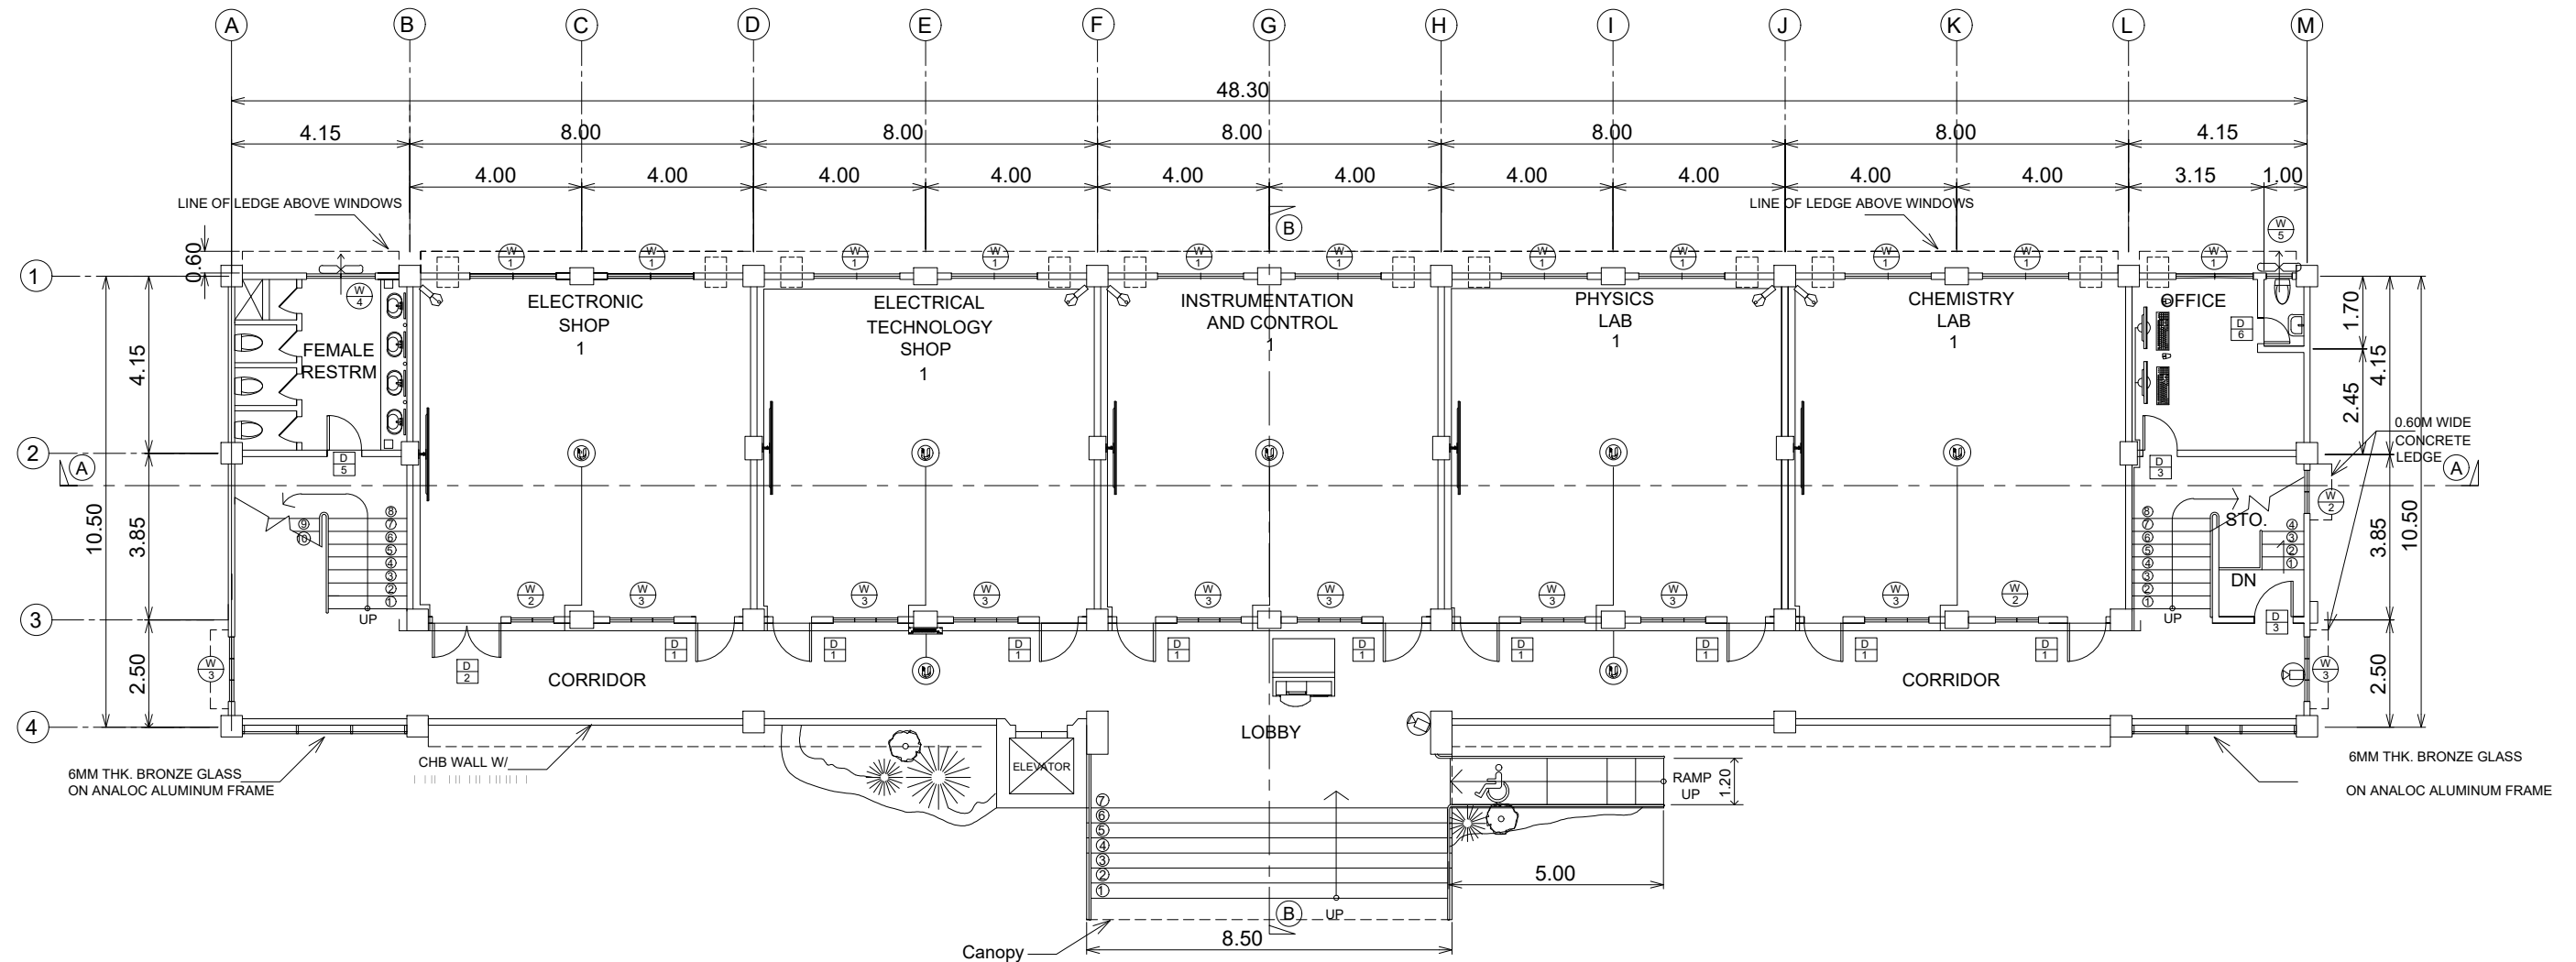


FIVE STOREY BATSTATEU CIT BUILDING **UPPER GROUND FLOOR LAYOUT**

SCALE: 1:100 M

 SQUADRON MONITORING INCORPORATED	ARCHITECT/CIVIL ENGINEER		SEAL	PROJECT / LOCATION: FIVE STOREY BATSTATEU CIT BUILDING BatstateU Alangilan Campus Golden Country, Alangilan, Batangas City	OWNER BATANGAS STATE UNIVERSITY DR. TIRSO A. RONQUILLO UNIVERSITY PRESIDENT	DESIGNED:	AS-BUILT PLAN	SHEET CONTENT UPPER GROUND FLOOR PLAN	SHEET NO. A 2/4
	HERNANDEZ, ODRHEY SARMIENTO, JAMES CLINTON TRIVIO, ROCKEY MARZO					DRAWN/CAD:			
	PRC Reg No. PTR No.	Valid until: Issued on:	TIN: Issued at:			CHECKED: DATE:			