


FIVE STOREY BATSTATEU CIT BUILDING
LOWER GROUND FLOOR LAYOUT
SCALE: 1:100 M

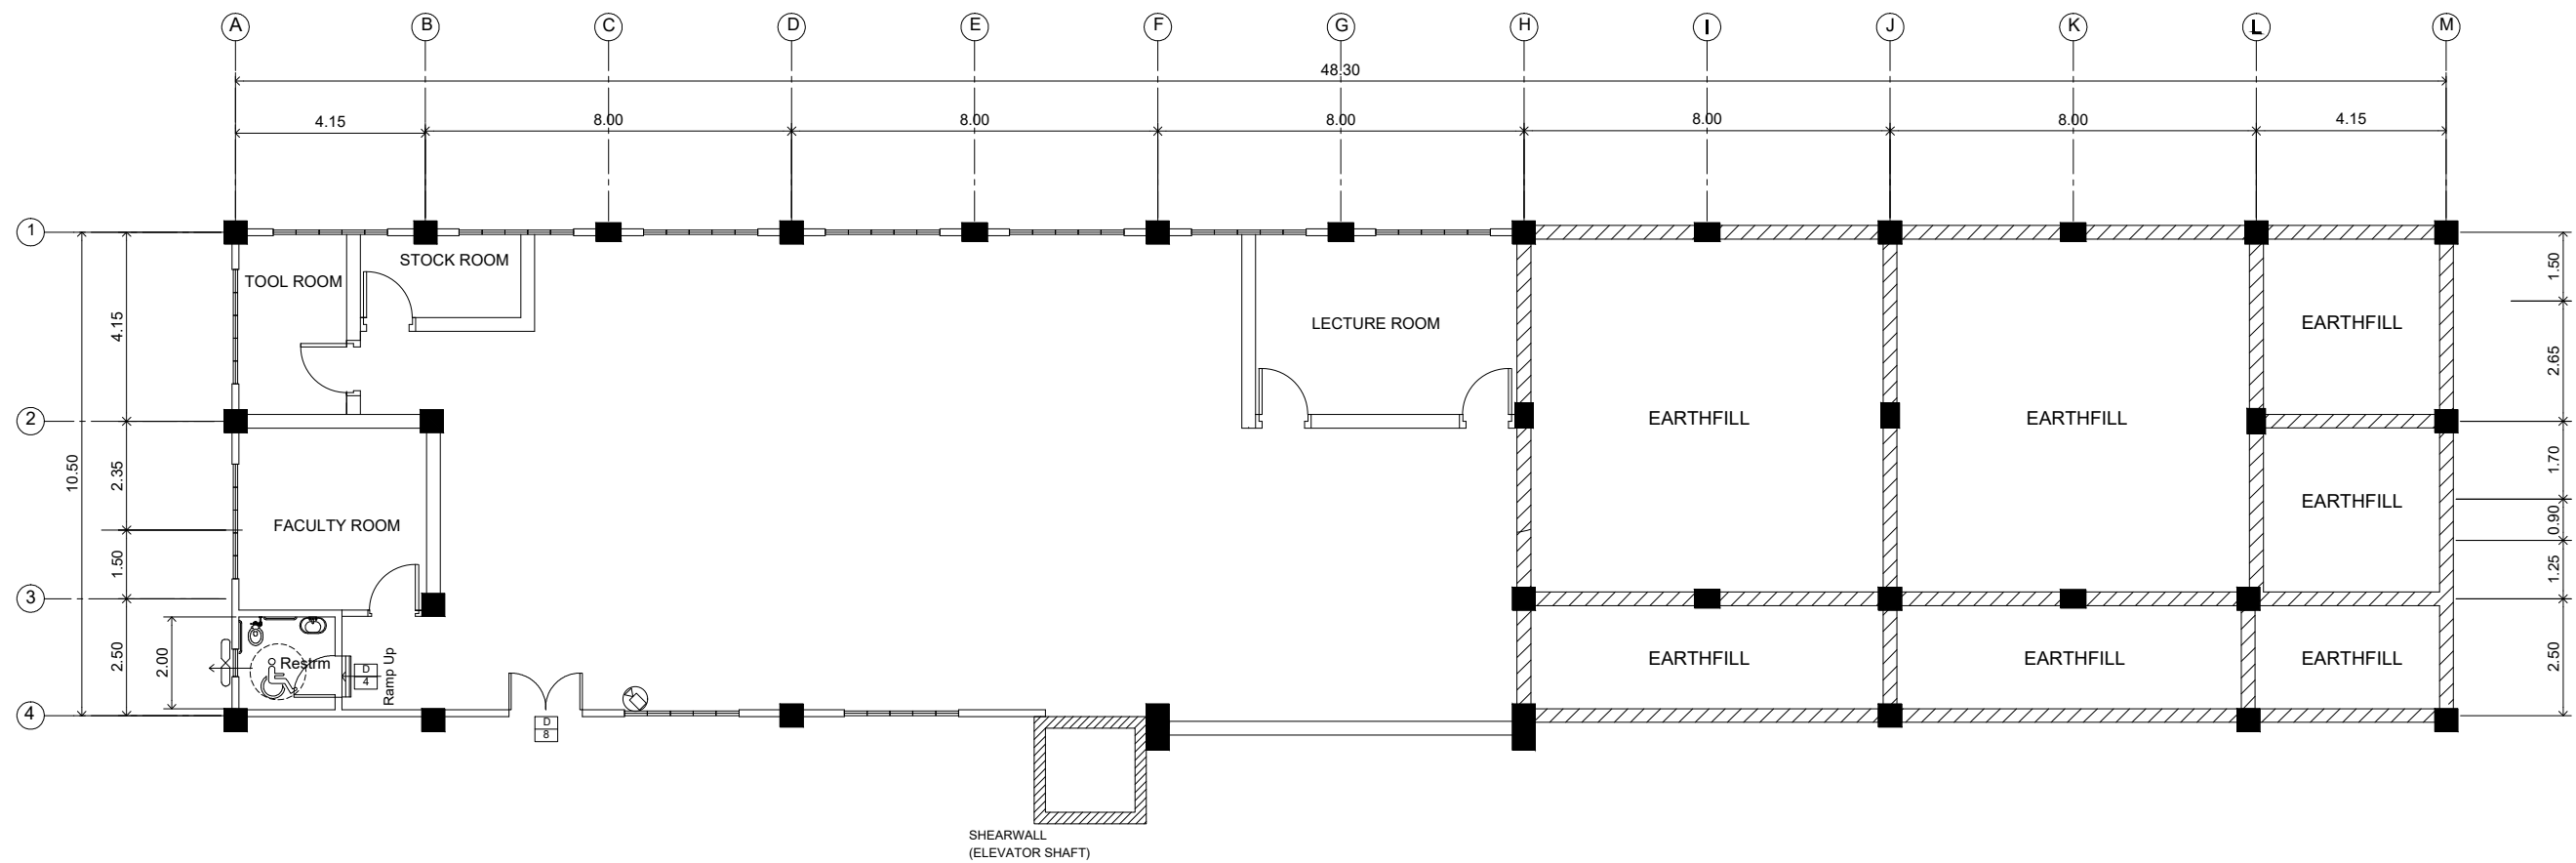

**DENAHRA ENGINEERING
SERVICES**

ARCHITECT/CIVIL ENGINEER			SEAL	PROJECT / LOCATION:	OWNER	DESIGNED:	AS-BUILT PLAN	SHEET CONTENT	SHEET NO.
DELLOSA, JAIRA MAE C. DIMAILIG, JANNAH JAINRECH B. PANALIGAN DESERIE ALIANA M.				FIVE STOREY BATSTATEU CIT BUILDING	BATANGAS STATE UNIVERSITY	DRAWN/CAD:		LOWER GROUND FLOOR PLAN	A 2/4
PRC Reg No.	Valid until:	TIN:		BatstateU Alangilan Campus	DR. TIRSO A. RONQUILLO	CHECKED:			
PTR No.	Issued on:	Issued at:		Golden Country, Alangilan, Batangas City	UNIVERSITY PRESIDENT	DATE:			